



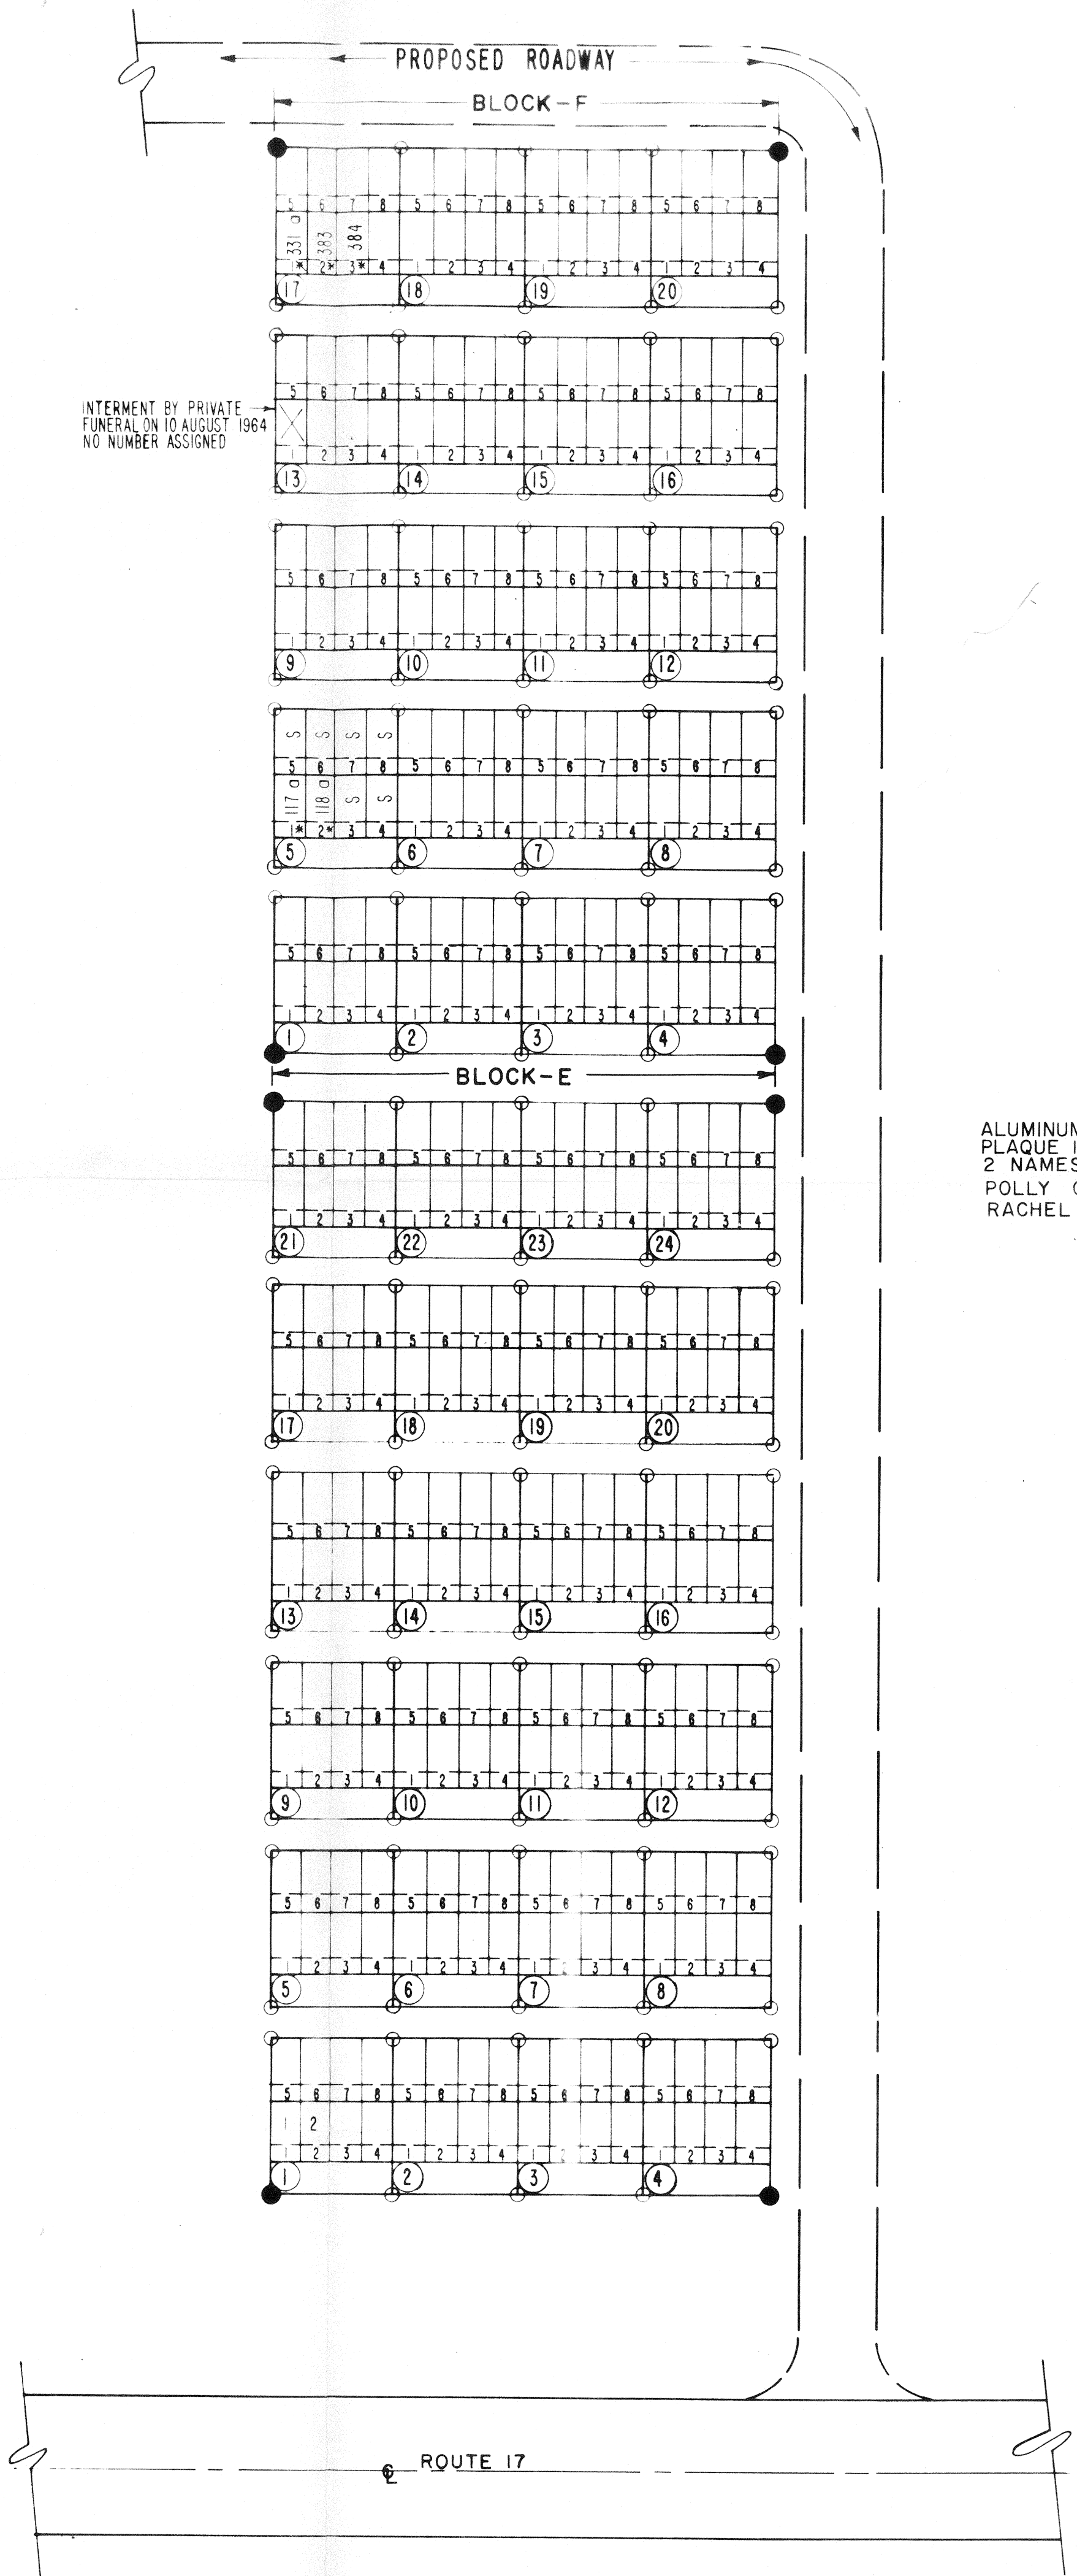

STEAMBURG CEMETERY
REINTERMENT SITE
SECTION - III
PLAN
NO SCALE

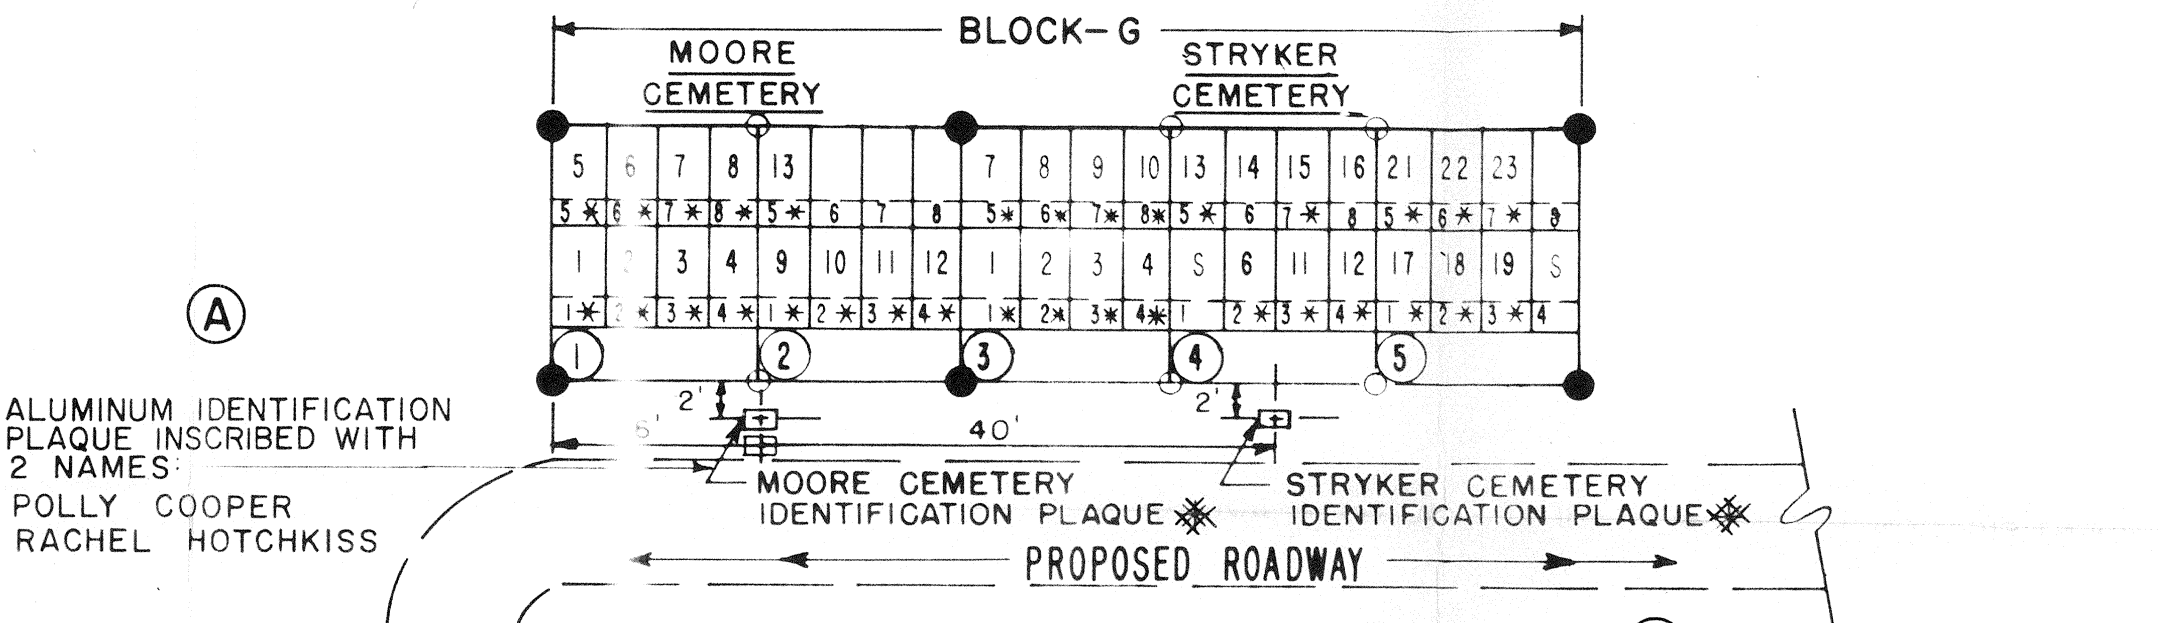

STEAMBURG CEMETERY
REINTERMENT SITE
SECTION - IV
PLAN
NO SCALE

NOTE:
GRAVE MARKERS SHOWN WITH ASTERISKS ARE TO
BE CONTRACTOR FURNISHED AND INSTALLED. FOR
DETAILS AND INSCRIPTION INFORMATION SEE DWG.
NO. 038-UI-69/85 AND GENERAL DATA SHEETS.

INTERMENT BY PRIVATE
FUNERAL ON 10 AUG. 1964
(NOT A CONTRACT ITEM)

SECTION	BLOCK	LOT	SPACE	NAME OF INTERRED
3	E	1	1	ALBERT L. SMITH
3	E	1	2	MARGUERITE E. SMITH
3	F	5	1	BETHANY ANN LINDBERG
3	F	5	2	JOHN A. LINDBERG
3	F	17	1	UNKNOWN
3	F	17	2	UNKNOWN
3	F	17	3	UNKNOWN
3	F	13	1	DIANE MARIE GORDON

INTERMENTS

SECTION	BLOCK	LOT	SPACE	NAME OF INTERRED
4	G	1	1	UNKNOWN
4	G	1	2	UNKNOWN
4	G	1	3	UNKNOWN
4	G	1	4	UNKNOWN
4	G	1	5	UNKNOWN
4	G	1	6	OSCAR W. MORRISON
4	G	1	7	UNKNOWN
4	G	1	8	BETSY HADLEY
4	G	2	1	UNKNOWN
4	G	2	2	UNKNOWN
4	G	2	3	UNKNOWN
4	G	2	4	UNKNOWN
4	G	2	5	UNKNOWN
4	G	2	6	UNKNOWN
4	G	2	7	UNKNOWN
4	G	2	8	UNKNOWN
4	G	3	1	HENRY BABCOCK
4	G	3	2	C.A. STRYKER
4	G	3	3	M.J. GARGILL
4	G	3	4	CATHERINE BROKAW
4	G	3	5	LYDIA S. BABCOCK
4	G	3	6	E.M. STRYKER
4	G	3	7	JOHN I. STRYKER
4	G	3	8	ANN STRYKER

SECTION	BLOCK	LOT	SPACE	NAME OF INTERRED
4	G	4	1	S
4	G	4	2	UNKNOWN
4	G	4	3	UNKNOWN
4	G	4	4	UNKNOWN
4	G	4	5	UNKNOWN
4	G	4	6	UNKNOWN
4	G	4	7	UNKNOWN
4	G	4	8	UNKNOWN
4	G	5	1	UNKNOWN
4	G	5	2	UNKNOWN
4	G	5	3	UNKNOWN
4	G	5	4	UNKNOWN
4	G	5	5	UNKNOWN
4	G	5	6	UNKNOWN
4	G	5	7	UNKNOWN
4	G	5	8	UNKNOWN
4	G	6	1	UNKNOWN
4	G	6	2	UNKNOWN
4	G	6	3	UNKNOWN
4	G	6	4	UNKNOWN
4	G	6	5	UNKNOWN
4	G	6	6	UNKNOWN
4	G	6	7	UNKNOWN
4	G	6	8	UNKNOWN
4	G	7	1	UNKNOWN
4	G	7	2	UNKNOWN
4	G	7	3	UNKNOWN
4	G	7	4	UNKNOWN
4	G	7	5	UNKNOWN
4	G	7	6	UNKNOWN
4	G	7	7	UNKNOWN
4	G	7	8	UNKNOWN
4	G	8	1	UNKNOWN
4	G	8	2	UNKNOWN
4	G	8	3	UNKNOWN
4	G	8	4	UNKNOWN
4	G	8	5	UNKNOWN
4	G	8	6	UNKNOWN
4	G	8	7	UNKNOWN
4	G	8	8	UNKNOWN

LEGEND

- *----- Grave Marker (Contractor Furnished)
- Grave Number
(Number appearing on individual grave space correspond to number shown on existing cemetery drawings.)
- Block Marker
- Lot Marker
- ①----- Block Number
(Number corresponds to the lot number shown on the existing cemetery drawings.)
- ▢----- Family Monument

A 20SEP65		DRAWING REVISED AS BUILT 6 AUGUST 1965		25R
REVISION	DATE	DESCRIPTION		BY
GRAPHIC SCALE				
NO SCALE				
U. S. ARMY ENGINEER DISTRICT, PITTSBURGH CORPS OF ENGINEERS OFFICE OF THE DISTRICT ENGINEER PITTSBURGH, PENNSYLVANIA				
ALLEGHENY RESERVOIR ALLEGHENY RIVER CEMETERY RELOCATIONS REINTERMENT SITE				
INTERMENT DATA-SECTION 3 & 4				
PREPARED BY: F. D.	DRAWN BY: M. G.	CHECKED BY: F. D.	SUBMITTED BY: [Signature]	APPROVED BY: [Signature]
ENGINEER'S DIVISION			DATE: 9 OCTOBER 1963	
APPROVED FOR:			SCALE: NO SCALE SPEC. NO.:	
DRAWING NUMBER: 038-UI-69/85 A.1			SHEET 5 OF 9	